

LABOR AND MATERIALS

Copper	Lead	} Connection		\$	
_____	_____	_____	_____	_____	_____
Curb	Cock Valve	} _____ in.			
_____	T.S. & V.				
Service box	Short 3-1/2 x 4-1/2	} _____ \$			
Old returned	Long 4-1/2 x 5-1/2				
Ft. _____ in.	Copper	} Pipe at _____ \$			
_____	G.I.				
_____	C.I.				
Nipples	_____ in.	at _____		\$	
Bushings	_____ to _____ in.	at _____		\$	
Red'g					
Inc'g					
Union	_____ in.	at _____		\$	
Meter	_____ in.	at _____		\$	


_____	Compound Joints at _____			\$	
_____	Maintenance Foreman _____			\$	
_____	Hrs. Water Maint. Man - 1 at _____			\$	
_____	Hrs. Water Maint. Man - 2 at _____			\$	
_____	Hrs. Garage Foreman _____ at _____			\$	
_____	Hrs. Labor _____ at _____			\$	
_____	Hrs. Compressor at _____			\$	

_____	Trucking _____			\$	
_____	Pav't Patch _____			\$	

St. _____
Pl. _____
Ave. No. _____

Name of Owner
10 EDISON

Labor and Mat'l. Report 19

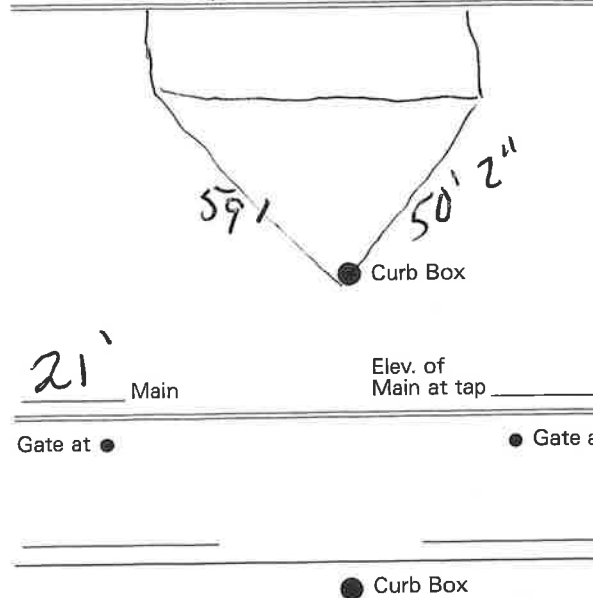

Elev. of Main at tap _____

Gate at ● Gate at ●

● Curb Box