


LABOR AND MATERIALS

1	Copper Lead	Connection	$\frac{3}{4}$ "	\$	
1	Curb	Cock Valve	1" in.	\$	
1	Service box	Short	$3\frac{1}{2} \times 4\frac{1}{2}$	\$	
	Old returned	Long	$4\frac{1}{2} \times 5\frac{1}{2}$	\$	
29'9"	3/4" COPPER	Copper		\$	
	Ft.	G.I.		\$	
				\$	
	Nipples	in. at		\$	
	Bushings	to in. at		\$	
	Red'g			\$	
	Inc'g	Coupl'gs to in. at		\$	
	Union	in. at		\$	
	Meter	in. at		\$	
				\$	
	Compound Joints	at		\$	
	Maintenance Foreman			\$	
	Hrs. Water Maint. Man-1	at		\$	
	Hrs. Water Maint. Man-2	at		\$	
	Hrs. Garage Foreman	at		\$	
	Hrs. Labor	at		\$	
	Hrs. Compressor	at		\$	
				\$	
	Trucking			\$	
	Pav't Patch			\$	
				\$	
				\$	
				\$	
				\$	

St. 41
ELIZABETH Ave. No. 1
 Name of Owner

Labor and Mat'l. Report APR. 10 1924

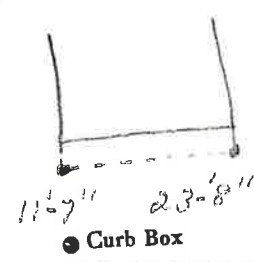

6" Main Elev. of Main at tap 5'
 Gate at ● Gate at ●

● Curb Box