


LABOR AND MATERIALS

1	Copper	} Connection $\frac{3}{4}$	\$	
	Lead			
1	Curb	} Cock Valve T. S. & V. } $\frac{3}{4}$ in.	\$	
1	Service box		} Short $3\frac{1}{2} \times 4\frac{1}{2}$ Long $4\frac{1}{2} \times 5\frac{1}{2}$	\$
	Old returned			
12	Ft. $\frac{3}{4}$ in.	} Copper } Pipe at	\$	
	Nipples	in. at	\$	
	Bushings	to in. at	\$	
	Red'g	} Coupl'gs to in. at	\$	
	Inc'g			
	Union	in. at	\$	
	Meter	in. at	\$	
			\$	
	Compound Joints	at	\$	
	Maintenance Foreman		\$	
	Hrs. Water Maint. Man—1	at	\$	
	Hrs. Water Maint. Man—2	at	\$	
	Hrs. Garage Foreman	at	\$	
	Hrs. Labor—	at	\$	
	Hrs. Compressor	at	\$	
			\$	
	Trucking		\$	
	Pav't Patch		\$	
			\$	
			\$	
			\$	
			\$	

St. Ave. No. 14  
ELIZABETH

Name of Owner

Labor and Mat'l. Report AUG 6 1934

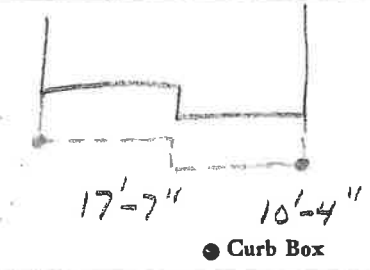

6" Main Elev. of Main at top 5'

Gate at • Gate at

• Curb Box

OLD SHUT OFF AT MAIN