


LABOR AND MATERIALS

1	Copper	} Connection $\frac{3}{4}$		\$
	Lead			
1	Curb	} Cock Valve } $\frac{3}{4}$ in.		\$
			T. S. & V.	
1	Service box	} Short $3\frac{1}{2} \times 4\frac{1}{2}$ Long $4\frac{1}{2} \times 5\frac{1}{2}$		\$
	Old returned			
27	Ft. $\frac{3}{4}$ in.	} Copper G.I. G.I.	Pipe at	\$
	Nipples	in. at		\$
	Bushings	to in. at		\$
	Red'g	} Coupl'gs	to in. at	\$
	Inc'g			
	Union	in. at		\$
	Meter	in. at		\$
				\$
	Compound Joints	at		\$
	Maintenance Foreman			\$
	Hrs. Water Maint. Man-1	at		\$
	Hrs. Water Maint. Man-2	at		\$
	Hrs. Garage Foreman	at		\$
	Hrs. Labor	at		\$
	Hrs. Compressor	at		\$
				\$
	Trucking			\$
	Pav't Patch			\$
				\$
				\$
				\$
				\$

St. ELIZABETH No. 17

Name of Owner _____

Labor and Mat'l. Report AUG. 6 1934

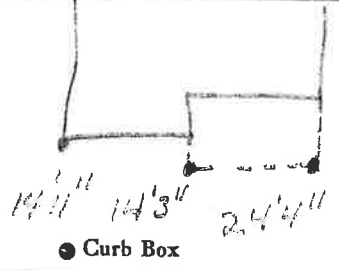

6 Main Elev. of Main at tap 5
 Gate at • Gate at •

• Curb Box

OLD SHUT OFF AT MAIN