


LABOR AND MATERIALS

1 Copper } Connection 3/4" \$ _____
 Lead }
 1 Curb } Cock } 3/4 in. \$ _____
 Valve }
 T. S. & V. }
 1 Service box { Short 3 1/2 x 4 1/2 }
 Old returned { Long 4 1/2 x 5 1/2 } \$ _____
 Buff or Rdway }
 30 Ft. 3/4 in. { Copper } Pipe at \$ _____
 { C.I. }
 { C.I. }
 Nipples in. at \$ _____
 Bushings to in. at \$ _____
 Red'g }
 Inc'g } Coupl'gs to in. at \$ _____
 Union in. at \$ _____
 Meter in. at \$ _____
 Lead Joints at \$ _____
 Compound Joints at \$ _____
 Maintenance Foreman \$ _____
 Hrs. Water Maint. Man—1 at \$ _____
 Hrs. Water Maint. Man—2 at \$ _____
 Hrs. Garage Foreman at \$ _____
 Hrs. Labor— at \$ _____
 Hrs. Compressor at \$ _____
 Compensation Ins. at \$ _____ per C \$ _____
 Trucking \$ _____
 Pav't Patch \$ _____
 Tap by Gifford & Co. \$ _____
5-26-67, \$ _____
 O'head \$ _____
 \$ _____

Elizabeth St. 3
 Ave. No. 3

Name of Owner
Mrs. Joseph Lehan,

Labor and Mat'l. Report May 26 1967

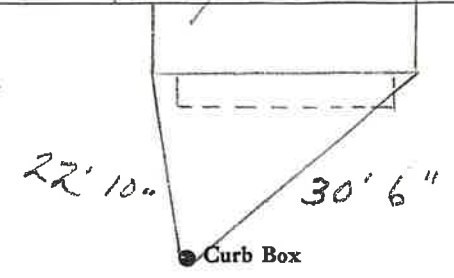

6" Main Elev. of Main at tap 4 1/2'
 Gate at • Gate at

• Curb Box