


LABOR AND MATERIALS

1	Copper Lead	} Connection $\frac{3}{4}$	\$
1	Curb		\$
		} $\frac{3}{4}$ in.	\$
1	Service box Old returned	} { Short $3\frac{1}{2} \times 4\frac{1}{2}$ Long $4\frac{1}{2} \times 5\frac{1}{2}$ }	\$
13	Ft. $\frac{3}{4}$ in.	} { Copper C.I. C.I. }	\$
	Nipples	in. at	\$
	Bushings	to in. at	\$
	Red'g } Inc'g }	} Coupl'gs. to in. at	\$
	Union	in. at	\$
	Meter	in. at	\$
	Compound Joints	at	\$
	Maintenance Foreman		\$
	Hrs. Water Maint. Man-1	at	\$
	Hrs. Water Maint. Man-2	at	\$
	Hrs. Garage Foreman	at	\$
	Hrs. Labor	at	\$
	Hrs. Compressor	at	\$
	Trucking		\$
	Pav't Patch		\$
			\$
			\$
			\$
			\$

St. 4
ELIZABETH Ave. No. 4
 Name of Owner

Labor and Mat'l. Report APR. 13 1931

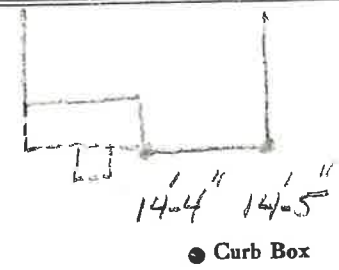

6" Main Elev. of Main at tap 5 1/2'
 Gate at • • Gate at

• Curb Box

OLD TAP DISCONNECTED