

LABOR AND MATERIALS


1	Copper	} Connection	3/4"	\$ 3.08
	Lead			
1	Curb	} Cock Valve T. S. & V.	3/4 in.	\$ 3.89
1	Service box			
	Old returned			
			Short 3 1/2 x 4 1/2 Long 4 1/2 x 5 1/2 Buff or Rdway	\$ 4.32
28	Ft. 3/4 in.	} Pipe at	45	\$ 12.60
	Nipples	in. at		\$
	Bushings	to in. at		\$
	Red'g	} Coupl'gs	to in. at	\$
	Inc'g			
	Union	in. at		\$
	Meter	in. at		\$
	Lead Joints at			\$
	Compound Joints at			\$
5	Maintenance Foreman	1.937		\$ 9.69
	Hrs. Water Maint. Man	1 at		\$
8	Hrs. Water Maint. Man	2 at 1.613		\$ 12.90
5	Hrs. Garage Foreman	1.62 at 1.481		\$ 7.41
16	Hrs. Labor	at 1.30		\$ 20.80
	Hrs. Compressor at			\$
	Compensation Ins. at \$ 5.696 per C			\$ 2.89
	Trucking			\$ 1.56
	Pay't Patch			\$ 18.45
	Team made Oct 9-56			\$
	By G. S. Ford & Co.			\$
	O'head			\$
				\$ 97.53

7908

Elizabeth St. Pl. Ave. No. 5

Name of Owner  
Worster

Labor and Mat'l. Report Oct 9 1956

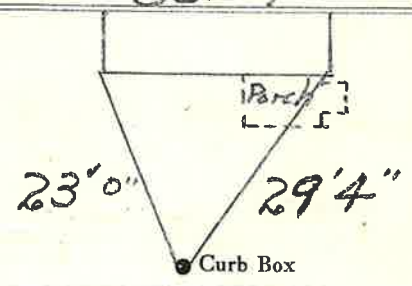

6" Main Elev. of Main at tap 5'  
Gate at • Gate at

• Curb Box