

LABOR AND MATERIALS

1	Copper	Connection	3/4"	\$	3.08
	Lead				
1	Curb	Cock Valve	3/4 in.	\$	3.89
		T.S. & V.			
	Service box	Short 3 1/2 x 4 1/2		\$	4.32
	Old returned	Long 4 1/2 x 5 1/2			
		Buff or Rdway			
12	Ft.	3/4 in. Copper	Pipe at 45	\$	5.40
		G.I.			
		G.I.			
	Nipples	in. at		\$	
	Bushings	to in. at		\$	
	Red'g	Coupl'gs to in. at		\$	
	Inc'g			\$	
	Union	in. at		\$	
	Meter	in. at		\$	
	Lead Joints	at		\$	
	Compound Joints	at		\$	
	Maintenance Foreman			\$	13.50
	Hrs. Water Maint. Man-1	at		\$	
\$	Hrs. Water Maint. Man-2	at 1.613		\$	12.90
	Hrs. Garage Foreman	at		\$	
\$	Hrs. Labor	at 1.30		\$	10.40
	Hrs. Compressor	at		\$	
	Compensation Ins. at	\$ 5.686 per C		\$	1.32
	Trucking			\$	1.50
	Pav't Patch			\$	9.00
	Tap by Gifford			\$	
	4-18-56			\$	
	O'head			\$	
				\$	51.81

St.
~~Pl.~~
Ave. No. 6


Elizabeth

Name of Owner

Kennedy

Labor and Mat'l. Report

April 18 1956

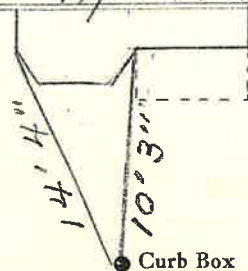

6" Main

Elev. of
Main at tap 5'

Gate at ●

● Gate at

● Curb Box

LABOR AND MATERIALS

_____	Copper } Connection _____	\$ _____
_____	Lead } _____	\$ _____
_____	Curb } Cock } _____ in. _____	\$ _____
	} Valve } _____	
	} T.S. & V. } _____	
_____	Service box { Short 3-1/2 x 4-1/2 } _____	\$ _____
_____	Old returned { Long 4-1/2 x 5-1/2 } _____	\$ _____
_____	Ft. _____ in. { Copper } Pipe at _____	\$ _____
	} G.I. }	
	} C.I. }	
_____	Nipples _____ in. at _____	\$ _____
_____	Bushings _____ to _____ in. at _____	\$ _____
_____	Red'g _____	\$ _____
_____	Inc'g _____	\$ _____
_____	Union _____ in. at _____	\$ _____
_____	Meter _____ in. at _____	\$ _____
_____	_____	\$ _____
_____	Compound Joints at _____	\$ _____
_____	Maintenance Foreman _____	\$ _____
_____	Hrs. Water Maint. Man - 1 at _____	\$ _____
_____	Hrs. Water Maint. Man - 2 at _____	\$ _____
_____	Hrs. Garage Foreman _____ at _____	\$ _____
_____	Hrs. Labor _____ at _____	\$ _____
_____	Hrs. Compressor at _____	\$ _____
_____	_____	\$ _____
_____	Trucking _____	\$ _____
_____	Pav't Patch _____	\$ _____
_____	_____	\$ _____
_____	_____	\$ _____
#6 Elizabeth

St. _____
Pl. _____
Ave. No. _____

Name of Owner

Wm Farrell, 761-6721

Labor and Mat'l. Report 19

