

LABOR AND MATERIALS


1	Copper	} Connection	3/4" iron to iron	\$
1	Lead			
1	Curb	} Cock Valve T.S. & V.	3/4" in. stop Waste	\$
1	Service box Old returned			
		} Short 3 1/2 x 4 1/2 Long 4 1/2 x 5 1/2 Buff or Rdway		\$
9	Ft. 3/4 in.		} Copper C.I. C.I.	} Pipe at
	Nipples			
	Bushings			\$
	Red'g } Inc'g	} Coupl'gs	to in. at	\$
	Union			
	Meter			\$
	Lead Joints at			\$
	Compound Joints at			\$
	Maintenance Foreman			\$
	Hrs. Water Maint. Man-1 at			\$
	Hrs. Water Maint. Man-2 at			\$
	Hrs. Garage Foreman at			\$
	Hrs. Labor at			\$
	Hrs. Compressor at			\$
	Compensation Ins. at \$		per C	\$
	Trucking			\$
	Pav't Patch			\$
	Tap by Peck & Co.			\$
	5-19-71			\$
	O'head			\$



St. Pl. Ave. No. 2


Name of Owner Monsieur

Labor and Mat'l. Report May 19 1971

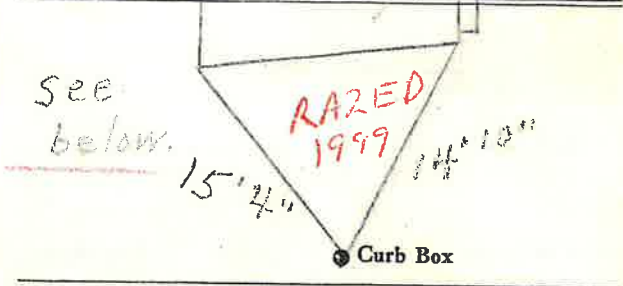

6" Main Elev. of Main at tap 8"

Gate at • Gate at •
Gate 6' 9" 5' 0" from Hydrant.
Tap 6" South of Independent

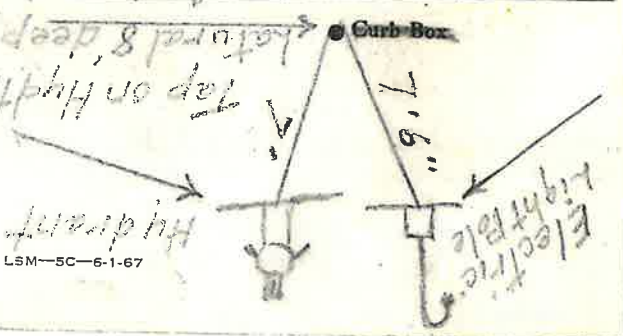


LSM-5C-6-1-67

LSM-SC-6-1-67



Tap on Hydt. natural 8' deep.
 Tap 9" south of independent gate 6' 9" from Hydrant.

Gate at ● Gate at ●
 Main 6" Main at tap 8"

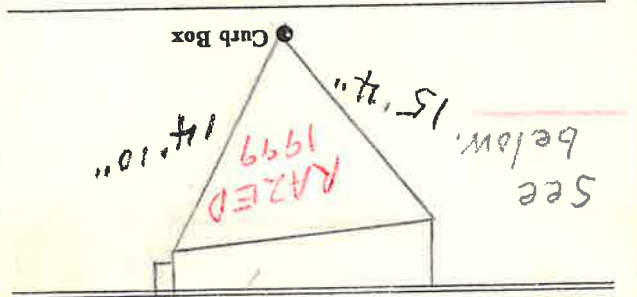

See below.
 RAZED 1999
 14.10"

LABOR and MAT'L. Report
 May 19 71

Name of Owner
 Elm
 St. TT Ave. No. 2