

LABOR AND MATERIALS


_____	Copper } Connection	_____	\$
_____	Lead } Cock		
_____	Curb } Valve	_____ in.	\$
		T.S. & V. }	
_____	Service box { Short 3-1/2 x 4-1/2	_____	\$
_____	Old returned { Long 4-1/2 x 5-1/2	_____	\$
_____	Ft. _____ in. { Copper	_____ Pipe at	\$
		G.I. }	
		C.I. }	
_____	Nipples _____ in.	at _____	\$
_____	Bushings _____ to _____ in.	at _____	\$
_____	Red'g		
_____	Inc'g		
_____	Union _____ in.	at _____	\$
_____	Meter _____ in.	at _____	\$
_____			\$
_____	Compound Joints at _____		\$
_____	Maintenance Foreman _____		\$
_____	Hrs. Water Maint. Man - 1 at _____		\$
_____	Hrs. Water Maint. Man - 2 at _____		\$
_____	Hrs. Garage Foreman _____ at _____		\$
_____	Hrs. Labor _____ at _____		\$
_____	Hrs. Compressor at _____		\$
_____			\$
_____	Trucking _____		\$
_____	Pav't Patch _____		\$
_____			\$
_____			\$
ELM

St. 20
Pl. Ave. No.

Name of Owner _____

Labor and Mat'l. Report 18

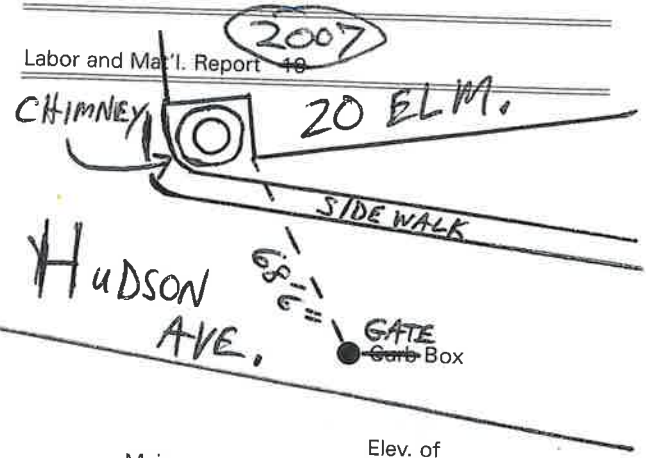

_____ Main Elev. of Main at tap _____

Gate at ● Gate at ●

● Curb Box

SEWER TAP ON ELM ST.