

LABOR AND MATERIALS


1	Copper Lead	} Connection $\frac{3}{4}$	\$
1	Curb		} Cock Valve T. S. & V. } $\frac{3}{4}$ in.
1	Service box Old returned	} Short $3\frac{1}{2} \times 4\frac{1}{2}$ } Long $4\frac{1}{2} \times 5\frac{1}{2}$ }	
25	Ft. $\frac{3}{4}$ in.		} Copper } Pipe at
	Nipples	in. at	
	Bushings	to in. at	\$
	Red'g Inc'g	} Coupl'gs to in. at	\$
	Union		in. at
	Meter	in. at	\$
	Compound Joints	at	\$
	Maintenance Foreman		\$
	Hrs. Water Maint. Man—1	at	\$
	Hrs. Water Maint. Man—2	at	\$
	Hrs. Garage Foreman	at	\$
	Hrs. Labor—	at	\$
	Hrs. Compressor	at	\$
	Trucking		\$
	Pav't Patch		\$
			\$
			\$
			\$
			\$

ELM

St. ~~St.~~ Ave. No. 42

Name of Owner
TAX ID #309.28-1-17

Labor and Mat'l. Report APR. 25 19 34

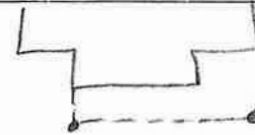

19-3 21-5

● Curb Box

6" Main

Elev. of Main at tap $5\frac{1}{2}'$

Gate at ●

● Gate at

● Curb Box

OLD TAP TO BE DISCONNECTED
NOTE - THIS SERVICE FEEDS
BOTH #42 + #42 1/2