

Labor and Materials

1	Copper } Connection	3	\$ 2.60
1	Lead } Cock Valve	4	\$ 2.27
	T-S-&V.	4	
1	Service Box		\$ 1.59
	Old returned		
25	Ft. in. } Copper Galv. Iron Pipe at	3	\$ 4.50
	Cast Iron	4	
	Nipples in. at.		\$
	Bushings to in. at.		\$
	Red'g } Couplings to in. at.		\$
	Inc'g }		\$
	Union in. at.		\$
	Meter in. at.		\$
	Lbs. Br. Stone at.		\$
	Lbs. Sand at.		\$
	Bags Cement at.		\$
	Paving Brick } Mack Red Asphalt } at.		\$
	Lead Joints at.		\$
	Leadite Joints at.		\$
3	Hrs. Foreman at.		\$ 1.88
6	Hrs. Common Labor at.		\$ 2.70
	Hrs. Common Labor at.		\$
	Hrs. Mason at.		\$
	Hrs. Mason's Helper at.		\$
	Hrs. Compressor at.		\$
	Compensation Ins.		\$.14
	Trucking		\$ 1.00
	Builders' Use of Water		\$
	<i>in Patch Sewer</i>		\$
	Total \$		16.68


42 1/2 Elm

31-213

Labor and Material Report

10-7-1931

Rear 42 Elm
Measured from #42

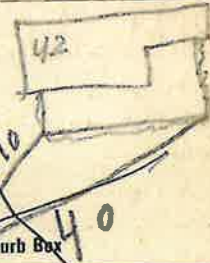

See Below

6 Main

Elev of Main at tap 6

Gate at ●

● Gate at

1 service for both 42 + 42 1/2
New House

Curb stop for #42
also for 42 1/2
1 shot off for both
house

See Card for #42