

LABOR AND MATERIALS

1	Copper	} Connection $\frac{3}{4}$	\$ 1.31
1	Lead		
1	Curb	} $\frac{3}{4}$ in.	\$ 1.75
	Valve T. S. & V.		
1	Service Box	} Short $\frac{3}{4} \times \frac{1}{2}$ Long $4\frac{1}{2} \times 5\frac{1}{2}$ Buff. or Rdway	\$ 1.60
	Old returned		
6	Ft. $\frac{3}{4}$ in.		
		} Copper Galv. Iron Cast Iron	Pipe at 18 \$ 1.08
	Nipples	in. at	\$
	Bushings	to in. at	\$
	Red'g Inc'g	} Couplings	to in. at \$
	Union	in. at	\$
	Meter	in. at	\$
	Lead Joints	at	\$
	Leadite Joints	at	\$
	Hrs. Foreman	at	\$
2	Hrs. Chauffeur	at 62 1/2	\$ 1.25
1	Hrs. Tapper	at	\$ 63
6	Hrs. Labor	at 45	\$ 270
	Hrs. Labor	at	\$
	Hrs. Compressor	at	\$
	Compensation Ins.		\$ 14
	Trucking		\$ 1.5
	Builders Use of Water		\$
	Tap by Miller		\$
			\$
			\$
			\$
			\$
			\$ 1146

74 - - 1940.

St.

Pl


Elm

Ave. No. 61

Name of Owner

Sinans

Labor and Mat'l. Report JUNE 30 1940

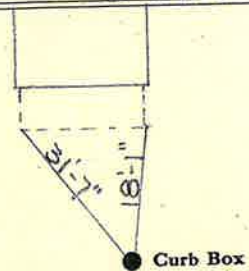

Elev. of Main at top 5'

Gate at ●

● Gate at

● Curb Box