

**Labor and Materials**


1	Copper	Connection	$\frac{3}{4}$	\$ 2.70
1	Lead	in.	$\frac{3}{4}$	\$ 2.39
1	Curb	Cock Valve T.S. & V.		
1	Service Box	Short $2\frac{1}{2} \times 4\frac{1}{2}$		\$ 1.55
	Old returned	Long $4\frac{1}{2} \times 5\frac{1}{2}$		
8	Pt.	Copper Galv. Iron	$\frac{3}{4}$	\$ 2.16
	Nipples	in. at		\$
	Bushings	to in. at		\$
	Red'g Inc'g	Couplings to in. at		\$
	Union	in. at		\$
	Meter	in. at		\$
	Lbs. Br. Stone	at		\$
	Lbs. Sand	at		\$
	Bags Cement	at		\$
	Paving Brick	Mack Red Asphalt at		\$
	Lead Joints	at		\$
	Leadite Joints	at		\$
3	Hrs. Foreman	at		\$ 1.88
1.6	Hrs. Common Labor	at		\$ 1.20
	Hrs. Common Labor	at		\$
	Hrs. Mason	at		\$
	Hrs. Mason's Helper	at		\$
	Hrs. Compressor	at		\$
	Compensation Ins.			\$ 2.8
	Trucking			\$ 1.00
	Builders' Use of Water	Patch		\$ 5.00
Total \$				24.16

30-150

Labor and Material Report

OCT. 22 1930

65 ELM ST.

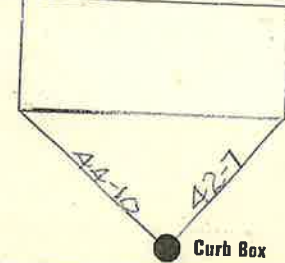

6" Main

Elev of Main at tap

5 1/2'

Gate at ●

● Gate at

● Curb Box

- OLD HOUSE RAZED

- OLD TAP TO BE DUG UP