


LABOR AND MATERIALS

1	Copper Lead	} Connection $\frac{3}{4}$	\$
1	Curb		} Cock Valve } $\frac{3}{4}$ in. \$
		T. S. & V.	
1	Service box Old returned	} Short $3\frac{1}{2} \times 4\frac{1}{2}$ Long $4\frac{1}{2} \times 5\frac{1}{2}$	\$
26	Ft. $\frac{3}{4}$ in.		} Copper Pipe at
	Nipples	in. at	
	Bushings	to in. at	\$
	Red'g Inc'g	} Coupl'gs	to in. at \$
	Union		
	Meter	in. at	\$
	Compound Joints	at	\$
	Maintenance Foreman		\$
	Hrs. Water Maint. Man—1	at	\$
	Hrs. Water Maint. Man—2	at	\$
	Hrs. Garage Foreman	at	\$
	Hrs. Labor—	at	\$
	Hrs. Compressor	at	\$
	Trucking		\$
	Pav't Patch		\$
			\$
			\$
			\$
			\$

St. ELM No. 70

Name of Owner _____

Labor and Mat'l. Report NOV. 1927

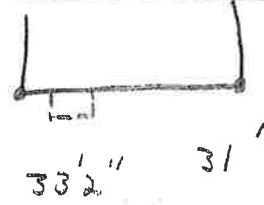

● Curb Box

6" Main Elev. of Main at tap 5'

Gate at ● Gate at ●

● Curb Box

OLD TAP DISCONNECTED