

LABOR AND MATERIALS

Copper	} Connection	_____	\$ _____		
Lead					
Curb	} Cock Valve T. S. & V. }	_____ in.	\$ _____		
Service box	} Short 3 1/2 x 4 1/2 } Long 4 1/2 x 5 1/2 }	_____	\$ _____		
Old returned					
Ft. <u>2</u> in.	} Copper G.I. G.I. }	Pipe at _____	\$ _____		
Nipples _____	in. at _____		\$ _____		
Bushings _____	to _____ in. at _____		\$ _____		
Red'g } Inc'g }	} Coupl'gs _____ to _____ in. at _____		\$ _____		
Union _____		in. at _____	\$ _____		
Meter _____	in. at _____		\$ _____		
			\$ _____		
Compound Joints at _____			\$ _____		
Maintenance Foreman _____			\$ _____		
Hrs. Water Maint. Man—1 at _____			\$ _____		
Hrs. Water Maint. Man—2 at _____			\$ _____		
Hrs. Garage Foreman _____	at _____		\$ _____		
Hrs. Labor— _____	at _____		\$ _____		
Hrs. Compressor at _____			\$ _____		
			\$ _____		
Trucking _____			\$ _____		
Pav't Patch _____			\$ _____		
			\$ _____		
			\$ _____		
			\$ _____		
			\$ _____		

ELM


St. ~~Pl.~~ Ave. No. 73

Name of Owner _____

TAX ID # 302.20-21-9

Labor and Mat'l. Report

1997

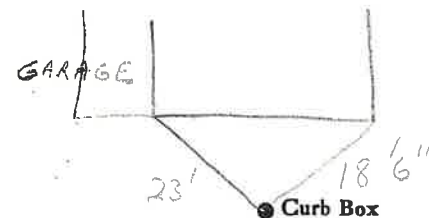

	Main	Elev. of Main at tap _____
Gate at ●		● Gate at

● Curb Box

Labor and Materials

Copper } Connection.....	3	\$ 2.70
Lead } Connection.....	3	\$ 2.29
Curb } Cock Valve } in.....	3	\$ 2.29
	T.S. & V.	
Service Box } Short 3/4x1 1/2 }		\$ 1.45
Old returned } Long 1 1/2x3 }		
	Buff or Rdway	
Ft.....in. } Copper } Pipe at.....	1	\$ 2.16
	Galv. Iron	
	Cast Iron	
Nipples.....in. at.....		\$
Bushings.....to.....in. at.....		\$
Red'g } Couplings.....to.....in. at.....		\$
Inc'g }		
Union.....in. at.....		\$
Meter.....in. at.....		\$
Lbs. Br. Stone at.....		\$
Lbs. Sand at.....		\$
Bags Cement 'at.....		\$
Paving Brick } Mack } at.....		\$
	Red	
	Asphalt	
Lead Joints at.....		\$
Leadite Joints at.....		\$
3 1/2 Hrs. Foreman at.....		\$ 2.19
6 Hrs. Common Labor at.....	Tapper @ .50	\$ 3.-
5 Hrs. Common Labor at.....		\$ 2.25
Hrs. Mason at.....		\$
Hrs. Mason's Helper at.....		\$
1 1/2 Hrs. Compressor at.....		\$ 2.25
Compensation Ins.....		\$ 23
Trucking.....		\$ 1.-
Builders' Use of Water.....	Pa 5th	\$ 5.-
Total \$		24.62

30-163

Labor and Material Report

14 1930

1375 Elm Street



6 Main

Elev of Main at tap

Gate at ●

● Gate at

● Curb Box

old tap disconnected

LABOR AND MATERIALS


_____ Copper } Connection _____ \$ _____
 _____ Lead }
 _____ Curb } Cock } _____ in. _____ \$ _____
 _____ Valve }
 _____ T.S. & V. }
 _____ Service box { Short 3-1/2 x 4-1/2 } _____ \$ _____
 _____ Old returned { Long 4-1/2 x 5-1/2 }
 _____ Ft. _____ in. { Copper } Pipe at _____ \$ _____
 _____ { G.I. }
 _____ { C.I. }
 _____ Nipples _____ in. at _____ \$ _____
 _____ Bushings _____ to _____ in. at _____ \$ _____
 _____ Red'g _____
 _____ Inc'g _____
 _____ Union _____ in. at _____ \$ _____
 _____ Meter _____ in. at _____ \$ _____
 _____ \$ _____
 _____ Compound Joints at _____ \$ _____
 _____ Maintenance Foreman _____ \$ _____
 _____ Hrs. Water Maint. Man - 1 at _____ \$ _____
 _____ Hrs. Water Maint. Man - 2 at _____ \$ _____
 _____ Hrs. Garage Foreman _____ at _____ \$ _____
 _____ Hrs. Labor _____ at _____ \$ _____
 _____ Hrs. Compressor at _____ \$ _____
 _____ \$ _____
 _____ Trucking _____ \$ _____
 _____ Pav't Patch _____ \$ _____
 _____ \$ _____
 _____ \$ _____
SLM St. _____
 Ave. No. 73

Name of Owner _____

Labor and Mat'l. Report ~~10~~ 4/11/13

OUTSIDE CLEAR OUT

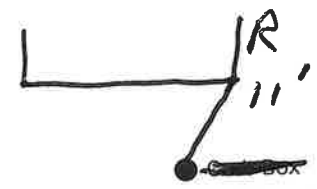

_____ Main Elev. of Main at tap _____
 Gate at ● Gate at ●

● Curb Box