


LABOR AND MATERIALS

1	Copper Lead	Connection	\$	_____
1	Curb	Cock Valve T.S. & V. Wheel 1" in.	\$	_____
1	Service box	Short 3 1/2 x 4 1/2	\$	_____
Old returned	Long 4 1/2 x 3 1/2			
		Buff or Rdway	\$	_____
Ft. 1"		Copper Pipe at	\$	_____
		G.I.	\$	_____
		C.I.	\$	_____
	Nipples	in. at	\$	_____
	Bushings	to in. at	\$	_____
	Red'g Inc'g	Coupl'gs to in. at	\$	_____
	Union	in. at	\$	_____
	Meter	in. at	\$	_____
	Lead Joints	at	\$	_____
	Compound Joints	at	\$	_____
	Maintenance Foreman		\$	_____
	Hrs. Water Maint. Man-1	at	\$	_____
	Hrs. Water Maint. Man-2	at	\$	_____
	Hrs. Garage Foreman	at	\$	_____
	Hrs. Labor	at	\$	_____
	Hrs. Compressor	at	\$	_____
	Compensation Ins.	at \$ per C	\$	_____
	Trucking		\$	_____
	Pav't Patch		\$	_____
	Measured in by Foster J. Miller.			\$
	8-29-57			\$
	O'head		\$	_____
			\$	_____

St. _____
 -Pl. _____
 Ave. No. 9-11

Name of Owner
 Scotty's Service Star
 Measured in
 Labor and Mat'l. Report - Aug. 29 1957

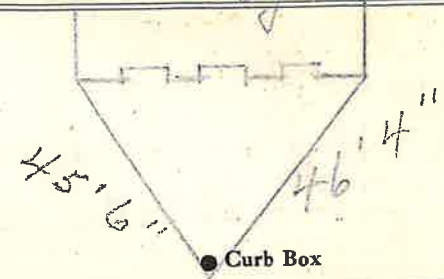

6" Main Elev. of Main at tap _____
 Gate at • Gate at •

• Curb Box
 1" Wheel Valve
 at curb.

LSM-5C-2-5 56
 Shut off at curb 9-17-1974