

LABOR AND MATERIALS

Copper	} Connection		\$
Lead			
1 Curb	} Cock Valve T.S.&V.	GATEBOX 6"	\$
			in.
Service box	} Short 3½ x 4½ } Long 4½ x 5½ }		\$
Old returned			\$
Ft. 6 in.	} Copper } G. I. } C. I. }	Pipe at	\$
Nipples	in. at		\$
Bushings	to in. at		\$
Red'g } Inc'g }	Coupl'gs	to in. at	\$
Union	in. at		\$
Meter	in. at		\$
			\$
Compound Joints at			\$
Maintenance Foreman			\$
Hrs. Water Maint. Man-1 at			\$
Hrs. Water Maint. Man-2 at			\$
Hrs. Garage Foreman at			\$
Hrs. Labor— at			\$
Hrs. Compressor at			\$
			\$
Trucking			\$
Pav't Patch			\$
			\$
			\$
			\$
			\$


13-19

ELM

St. ~~Pl.~~ No. 20

Name of Owner

Labor and Mat'l. Report JULY 13 1920

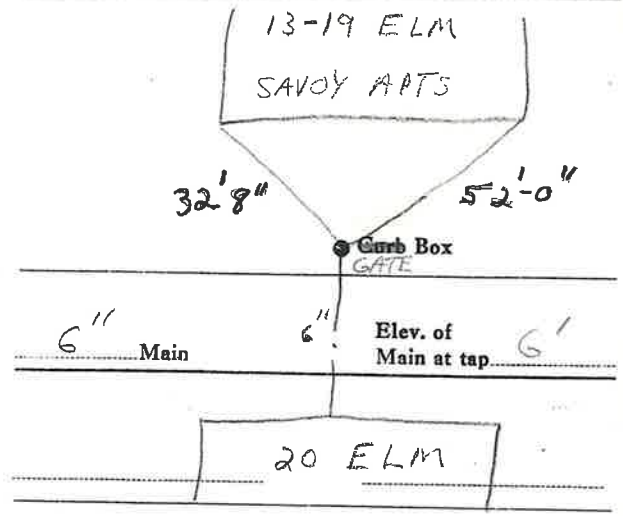

6" FIRE LINE WITH 4" TAP OFF
FIRE LINE