


LABOR AND MATERIALS

1 Copper } Connection 3/4" \$  
~~1~~ }  
 1 Curb } Cock } 3/4 in. (MARK II) \$  
 } Valve } (OYIS 2A1)  
 } T.S. & V. }  
 1 Service box } Short 3 1/2 x 4 1/2 } used old  
 Old returned } Long 4 1/2 x 5 1/2 } Curb Box  
 } Buff. or Redway } \$  
 12 Ft. 3/4 in. } Copper } Pipe at \$  
 } Gal. }  
 } C.I. }  
 Nipples in. at \$  
 Bushings to in. at \$  
 Red'g }  
 Inc'g } Coupl'gs. to in. at \$  
 Union in. at \$  
 Meter in. at \$  
 Lead Joints at \$  
 Compound Joints at \$  
 Maintenance Foreman \$  
 Hrs. Water Maint. Man-1 at \$  
 Hrs. Water Maint. Man-2 at \$  
 Hrs. Garage Foreman at \$  
 Hrs. Labor at \$  
 Hrs. Compressor at \$  
 Compensation Ins. at \$ per C \$  
 Trucking \$  
 Pav't Patch \$  
TAP MADE BY ST JOHN & CO \$  
MAY-16-1973 \$  
 O'head \$  
 \$

St. EMPIRE  
 Ave. No. 4

Name of Owner  
ELLIS LAFAVE

Labor and Mat'l. Report MAY 16 1973

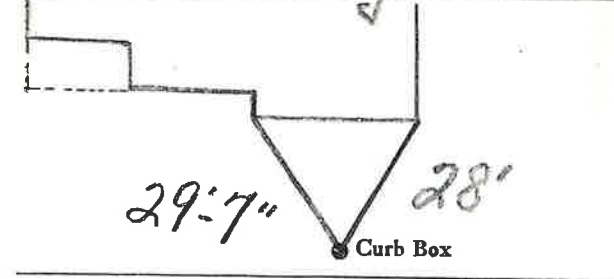

6" Main Elev. of Main at tap 5'  
 Gate at • Gate at •

• Curb Box