


LABOR AND MATERIALS

1	Copper	Connection	3/4"	\$	308
1	Lead	Cock	3/4 in.	\$	389
1	Curb	Valve	3/4 in.	\$	389
		T. O. & V.			
1	Service box	Short 3 1/2 x 4 1/2		\$	432
	Old returned	Long 4 1/2 x 5 1/2		\$	
		Buff. or Rdway		\$	
14	Ft.	Copper	Pipe at 45	\$	630
	3/4 in.	C.I.			
		C.I.			
	Nipples	in. at		\$	
	Bushings	to in. at		\$	
	Red'g			\$	
	Inc'g	Coupl'gs to in. at		\$	
	Union	in. at		\$	
	Meter	in. at		\$	
	Lead Joints at			\$	
	Compound Joints at			\$	
	Maintenance Foreman			\$	
	Hrs. Water Maint. Man-1 at			\$	
5	Hrs. Water Maint. Man-2 at	1.613		\$	80.7
	Hrs. Garage Foreman at			\$	
3	Hrs. Labor at	1.30		\$	390
	Hrs. Compressor at			\$	
	Compensation Ins. at \$5.686 per C			\$	68
	Trucking			\$	1.50
	Pav't Patch			\$	9.00
	Tap by Gizzard			\$	
	14-17-56			\$	
	O'head			\$	
				\$	40.74

Empire St. 16
Pl.
Ave. No.

Name of Owner
Vittengl

Labor and Mat'l. Report April 17 1956

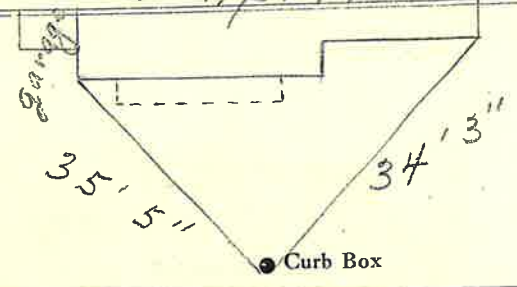

6" Main Elev. of Main at tap 5 1/2'

Gate at • Gate at

• Curb Box