

LABOR AND MATERIALS

1	Copper	} Connection	3/4" Oris eal	\$
1	Lead			
1	Curb	} Valve	3/4 in.	\$
1	Service box	} Short 3 1/2 x 4 1/2	}	\$
	Old returned			Long 4 1/2 x 5 1/2
		Buff or Rdway		\$
22	Ft. 3/4 in.	} Copper	} Pipe at	\$
				C.I.
		C.I.		\$
	Nipples	in. at		\$
	Bushings	to in. at		\$
	Red'g	} Coupl'gs	to in. at	\$
	Inc'g			
	Union	in. at		\$
	Meter	in. at		\$
	Lead Joints	at		\$
	Compound Joints	at		\$
	Maintenance Foreman			\$
	Hrs. Water Maint. Man-1	at		\$
	Hrs. Water Maint. Man-2	at		\$
	Hrs. Garage Foreman	at		\$
	Hrs. Labor	at		\$
	Hrs. Compressor	at		\$
	Compensation Ins. at \$	per C		\$
	Trucking			\$
	Pav't Patch			\$
	Tap by Gifford & Co.			\$
	4-6-64.			\$
	O'head			\$

Empire


St. Ave. No. 17

Name of Owner

Don Rozell

Labor and Mat'l. Report

Apr. 6 1964

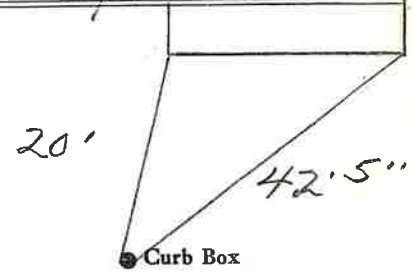

6" Main

Elev. of Main at tap 15'

Gate at ●

● Gate at

● Curb Box

This Tap on Shippy St.