

LABOR AND MATERIALS

1	Copper	} Connection $\frac{3}{4}$	\$
	Lead		
1	Curb	} Cock Valve } $\frac{3}{4}$ in.	\$
			F.S. & V.
1	Service box	} Short $3\frac{1}{2} \times 4\frac{1}{2}$	\$
	Old returned		
25	Ft. $\frac{3}{4}$ in.	} Copper Pipe at	\$
	Nipples	in. at	\$
	Bushings	to in. at	\$
	Red'g } Inc'g }	Coupl'gs to in. at	\$
	Union	in. at	\$
	Meter	in. at	\$
			\$
	Compound Joints	at	\$
	Maintenance Foreman		\$
	Hrs. Water Maint. Man-1	at	\$
	Hrs. Water Maint. Man-2	at	\$
	Hrs. Garage Foreman	at	\$
	Hrs. Labor	at	\$
	Hrs. Compressor	at	\$
			\$
	Trucking		\$
	Pav't Patch		\$
			\$
			\$
			\$
			\$


EVERTS

St. Ave. No. 16

Name of Owner

Labor and Mat'l. Report

9-14 1935

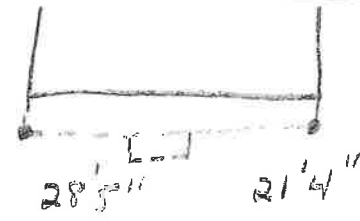

● Curb Box

6" Main (C.I.)

Elev. of Main at tap 5'

Gate at ●

● Gate at

● Curb Box

NEW TAP