

LABOR AND MATERIALS

1	Copper Lead	} Connection $\frac{3}{4}$	\$
1	Curb		} Cock Valve T.S. & V. } $\frac{3}{4}$ in.
1	Service box Old returned	} Short $3\frac{1}{2} \times 4\frac{1}{2}$ Long $4\frac{1}{2} \times 5\frac{1}{2}$	
31	Ft. $\frac{3}{4}$ in.		} Copper C.I. } Pipe at
	Nipples	in. at	
	Bushings	to in. at	\$
	Red'g Inc'g	} Coupl'gs to in. at	\$
	Union		in. at
	Meter	in. at	\$
	Compound Joints	at	\$
	Maintenance Foreman		\$
	Hrs. Water Maint. Man-1	at	\$
	Hrs. Water Maint. Man-2	at	\$
	Hrs. Garage Foreman	at	\$
	Hrs. Labor	at	\$
	Hrs. Compressor	at	\$
	Trucking		\$
	Pav't Patch		\$
			\$
			\$

EVENTS

Ave. No. 24

Name of Owner


Labor and Mat'l. Report

9-14 1935

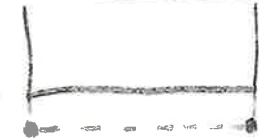

23' 8" 29'

● Curb Box

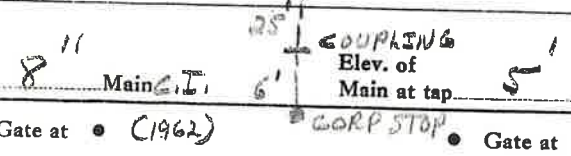

● Curb Box
 TAP EXTENDED AT TIME OF
 CHANGE OVER FROM 6" CEMENT
 MAIN TO 8" C.I.