


LABOR AND MATERIALS

Copper	} Connection	_____	\$ _____	
Lead				
Curb	} Cock	_____ in.	\$ _____	
				} Valve
Service box	} Short 3 1/2 x 4 1/2	_____	\$ _____	
Old returned				} Long 4 1/2 x 5 1/2
23 6 29 3/4 31 0 Ft.	3/4 in.	} Copper } C. I. } C. I.	} Pipe at _____	\$ _____
	Nipples _____ in. at _____			
	Bushings _____ to _____ in. at _____			
	Red'g } Coupl'gs _____ to _____ in. at _____	\$ _____		
	Inc'g }			
	Union _____ in. at _____	\$ _____		
	Meter _____ in. at _____	\$ _____		
	Lead Joints at _____	\$ _____		
	Compound Joints at _____	\$ _____		
	Maintenance Foreman _____	\$ _____		
	Hrs. Water Maint. Man-1 at _____	\$ _____		
	Hrs. Water Maint. Man-2 at _____	\$ _____		
	Hrs. Garage Foreman _____ at _____	\$ _____		
	Hrs. Labor- _____ at _____	\$ _____		
	Hrs. Compressor at _____	\$ _____		
	Compensation Ins. at \$ _____ per C _____	\$ _____		
	Trucking _____	\$ _____		
	Pav't Patch _____	\$ _____		
	_____	\$ _____		
	_____	\$ _____		
	_____	\$ _____		
	O'head _____	\$ _____		
	_____	\$ _____		

Everetts -SE
-Dir
Ave. No. 28

Name of Owner
Parson's

Labor and Mat'l. Report Measured in
April 7 1960

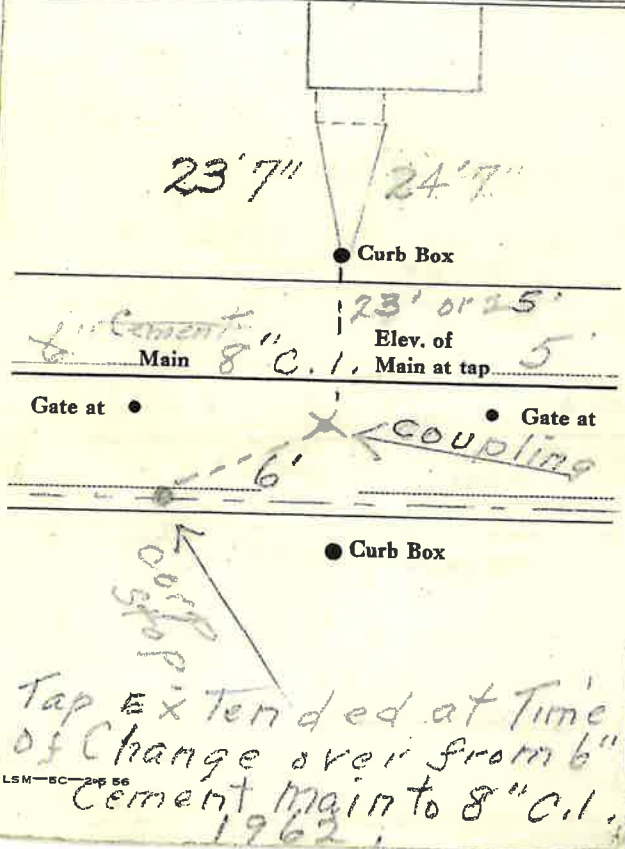

LSM-EC-2456