

LABOR AND MATERIALS

1	Copper Lead	Connection	8" x 6" tap	\$27.44
1	Curb	Clock Valve T. S. & V.	6" in.	\$27.00
1	Service box	Short 3" x 4"	}	\$ 9.00
	Old returned	Long 4" x 5"		
13'10"	6" in.	Copper Galv. Iron Cast Iron	Pipe at 1.05	\$ 14.51
	Nipples	in. at		\$
	Bushings	to in. at		\$
	Red'g Inc'g	Couplings	to in. at	\$
	Union	in. at		\$
	Meter	in. at		\$
	Lead Joints at			\$.56
6	Compound Joints at			\$ 2.20
2	Hrs. Foreman at			\$ 1.68
10	Hrs. Chauffeur at			\$ 7.50
	Hrs. Tapper at			\$
2	Hrs. Labor at			\$ 1.30
	Hrs. Labor at			\$
2	Hrs. Compressor at			\$ 2.00
	Compensation Ins.			\$.29
	Trucking			\$ 2.00
	Builders Use of Water			\$
	Port. Equip. A. 1.00			\$ 1.00
	Superv. & Hand			\$ 1.00
				\$
				\$
				\$ 121.02


54-46

St. Pl. Ave. No. 12114

Exchange

Name of Owner
Fowler Co 6" Tap
(Sprinkler System)

Labor and Mat'l. Report May 10 1946

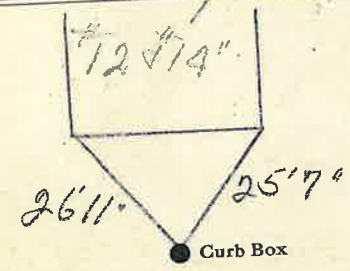

8 Main Elev. of Main at tap 5
Gate at ● Gate at ●

● Curb Box
6" SPRINKLER SYSTEM
Tap

LSM-5C-6-1-45 To be charged ✓

LABOR AND MATERIALS

1	Copper Lead	Connection	3/4		\$ 1.78	
1	Curb	Clock Valve T. S. & V.	3/4	in.	\$ 2.61	
1	Service box Old returned	Short 3 1/2 X 4 1/2 Long 4 1/2 X 5 1/2 Buff or Rdway				\$ 1.82
13	Ft.	3/4	in.	Copper Galv. Iron Cast Iron	Pipe at 23 \$ 2.99	
	Nipples	in.	at		\$ —	
	Bushings	to	in.	at	\$ —	
	Red'g inc'g	Couplings	to	in.	at \$ —	
	Union	in.	at		\$ —	
	Meter	in.	at		\$ —	
	Lead Joints	at			\$ —	
	Compound Joints	at			\$ —	
	Hrs. Foreman	at			\$ —	
3	Hrs. Chauffeur	at	.75		\$ 2.25	
11	Hrs. Tapper	at	.75		\$ 8.25	
	Hrs. Labor	at			\$ —	
3	Hrs. Labor	at	.65		\$ 1.95	
	Hrs. Compressor	at			\$ —	
	Compensation Ins.				\$ 34	
	Trucking				\$ 1.00	
	Builders Use of Water	Byou Parking			\$ —	
		Trip by Water			\$ —	
					\$ —	
					\$ —	
					\$ —	
					\$ 22.99	


53-146

St.
Pl:
Ave. No. 12114

Exchange

Name of Owner
Fowler Co 3/4" Tap

Labor and Mat'l. Report May 10 1946

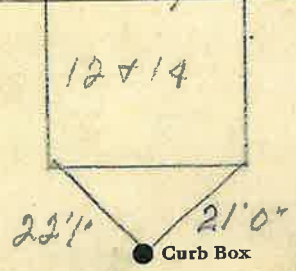

8 Main Elev. of Main at tap 5

Gate at ● Gate at ●

● Curb Box

LSM-5C-6-1-45

To be Charged ✓