

LABOR AND MATERIALS


|     |                         |                      |            |          |
|-----|-------------------------|----------------------|------------|----------|
| 1   | Copper                  | Connection           | 3/4"       | \$ 2.76  |
|     | Lead                    |                      |            |          |
| 1   | Curb                    | Cock Valve           | 3/4" in.   | \$ 3.49  |
|     |                         | T. S. & V.           |            |          |
| 1   | Service box             | Short 3/4" X 4 1/2"  |            | \$ 4.74  |
|     | Old returned            | Long 4 1/2" X 5 1/2" |            |          |
|     |                         | Buff or Rdway        |            |          |
| 12  | Ft.                     | Copper               | Pipe at 35 | \$ 420   |
|     |                         | G. I.                |            |          |
|     |                         | C. I.                |            |          |
|     | Nipples                 | in. at               |            | \$       |
|     | Bushings                | to in. at            |            | \$       |
|     | Red'g                   |                      |            | \$       |
|     | Inc'g                   | Coupl'gs to in. at   |            | \$       |
|     | Union                   | in. at               |            | \$       |
|     | Meter                   | in. at               |            | \$       |
|     | Lead Joints             | at                   |            | \$       |
|     | Compound Joints         | at                   |            | \$       |
| 8   | Hrs. Water Maint. Man-1 | at 1.34              |            | \$ 10.72 |
| 2   | Hrs. Water Maint. Man-2 | at 1.24              |            | \$ 2.48  |
| 3.7 | Hrs. Labor              | at 1.13              |            | \$ 36.16 |
|     | Hrs. Labor              | at                   |            | \$       |
| 7   | Hrs. Compressor         | at 1.50              |            | \$ 3.00  |
|     | Compensation Ins.       | at \$3.706 per C     |            | \$ 183   |
|     | Trucking                |                      |            | \$ 1.00  |
|     | Pav't Patch             |                      |            | \$ 11.76 |
|     |                         |                      |            | \$       |
|     |                         |                      |            | \$       |
|     | O'head                  |                      |            | \$       |

Tap by WARSINSKI \$83.14  
8-652

St. Exchange  
Pl. Ave. No. 19

Name of Owner Nelson

Labor and Mat'l. Report Aug. 6 1952

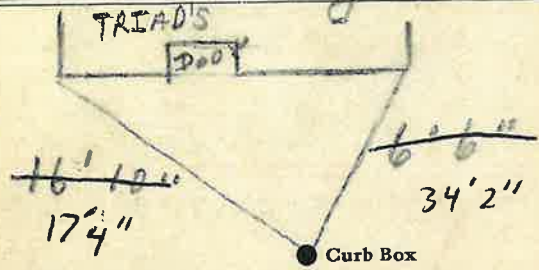

ADJ. - 2003 64  
8" Transite Main Elev. of Main at tap 5 1/2'

Gate at ● Gate at ●

● Curb Box