


Labor and Materials

1	Copper	Connection	\$ 3.20
1	Curb	{ Cock Valve P.S. V. } in.	\$ 1.00
1	Service Box Old returned	{ Short 3 1/2 x 4 1/2 Long 4 1/2 x 5 1/2 Bells or Redway }	\$ 1.34
8	Ft. 3/4	{ Copper Galv. Iron Cast Iron }	Pipe at.....	\$ 1.76
	Nipples in. at.....		\$
	Bushings to..... in. at.....		\$
	Red'g Inc'g	Couplings to..... in. at.....	\$
	Union in. at.....		\$
	Meter in. at.....		\$
	Lbs. Br. Stone	at.....		\$
	Lbs. Sand	at.....		\$
	Bags Cement	at.....		\$
	Paving Brick	{ Mack Red Asphalt }	at.....	\$
	Lead Joints	at.....		\$
	Leadite Joints	at.....		\$
1	Hrs. Foreman	at.....		\$ 63
1	Hrs. Common Labor	at.....		\$ 41
	Hrs. Common Labor	at.....		\$
	Hrs. Mason	at.....		\$
	Hrs. Mason's Helper	at.....		\$
	Hrs. Compressor	at.....		\$
	Compensation Ins.		\$ 0.3
	Trucking		\$ 1.00
	Builders' Use of Water		\$
Total \$				9.33

Labor and Material Report

Sept 5-25
D. C. 15 1925

Exeter St.

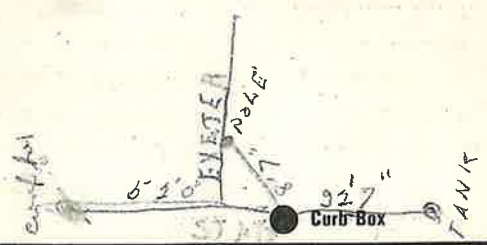

6" Main Elev. of Main at tap 5
 Gate at ● ● Gate at

● Curb Box

Tubbs. new tap