

LABOR AND MATERIALS

| | |
|--|--------------|
| Copper } Connection _____ | \$ _____ |
| Lead } _____ | |
| Curb } Cock Valve } _____ in. | \$ _____ |
| | T. S. & V. } |
| Service box } { Short 3 1/2 x 4 1/2 } | |
| Old returned } { Long 4 1/2 x 5 1/2 } | \$ _____ |
| Ft. ³ / ₄ in. } { Copper } Pipe at _____ | \$ _____ |
| | { G.I. } |
| | { C.I. } |
| Nipples _____ in. at _____ | \$ _____ |
| Bushings _____ to _____ in. at _____ | \$ _____ |
| Red'g } Coupl'gs. _____ to _____ in. at _____ | \$ _____ |
| Inc'g } _____ | |
| Union _____ in. at _____ | \$ _____ |
| Meter _____ in. at _____ | \$ _____ |
| _____ | \$ _____ |
| Compound Joints at _____ | \$ _____ |
| Maintenance Foreman _____ | \$ _____ |
| Hrs. Water Maint. Man—1 at _____ | \$ _____ |
| Hrs. Water Maint. Man—2 at _____ | \$ _____ |
| Hrs. Garage Foreman _____ at _____ | \$ _____ |
| Hrs. Labor— _____ at _____ | \$ _____ |
| Hrs. Compressor at _____ | \$ _____ |
| _____ | \$ _____ |
| Trucking _____ | \$ _____ |
| Pav't Patch _____ | \$ _____ |
| _____ | \$ _____ |
| _____ | \$ _____ |
| _____ | \$ _____ |
| _____ | \$ _____ |

FAXON


St. Ave. No. 3

Name of Owner

Cranell

Labor and Mat'l. Report

19 86

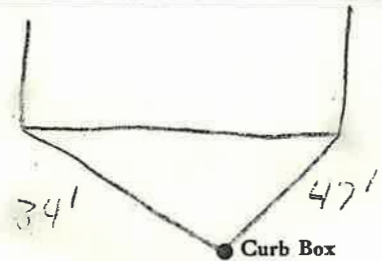

Main _____ Elev. of Main at tap _____
 Gate at • _____ • Gate at _____

TAX ID # 309.16-3-1

• Curb Box