


LABOR AND MATERIALS

1	Copper	} Connection $\frac{3}{4}$	\$
1	Lead		\$
1	Curb	} Cock Valve } $\frac{3}{4}$ in.	\$
			T.S. & W.
1	Service box	} Short $3\frac{1}{2}$ x $4\frac{1}{2}$	\$
	Old returned		Long $4\frac{1}{2}$ x $5\frac{1}{2}$
9	Ft. $\frac{3}{4}$ in.	} Copper	\$
			Cast Iron
	Nipples	in. at	\$
	Bushings	to in. at	\$
	Red'g	} Coupl'gs to in. at	\$
	Inc'g		\$
	Union	in. at	\$
	Meter	in. at	\$
	Compound Joints	at	\$
	Maintenance Foreman		\$
	Hrs. Water Maint. Man—1	at	\$
	Hrs. Water Maint. Man—2	at	\$
	Hrs. Garage Foreman	at	\$
	Hrs. Labor—	at	\$
	Hrs. Compressor	at	\$
	Trucking		\$
	Pav't Patch		\$
			\$
			\$
FIELDING St. No. 18

Name of Owner BENWAY

Labor and Mat'l. Report JULY 13 1938

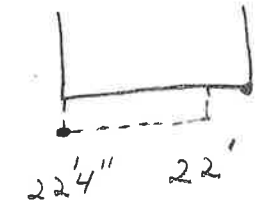

● Curb Box

6" Main Elev. of Main at tap $4\frac{1}{2}$ '

Gate at ● Gate at

● Curb Box

NEW TAP