

LABOR AND MATERIALS


1	Copper	Connection	$\frac{3}{4}$	\$
1	Curb	Cock Valve	$\frac{3}{4}$ in.	\$
1	Service box	Short $3\frac{1}{2} \times 4\frac{1}{2}$		\$
	Old returned	<del>Long <math>4\frac{1}{2} \times 5\frac{1}{2}</math></del>		\$
26	Ft.	Copper	Pipe at	\$
		$\frac{3}{4}$ in.		\$
	Nipples	in. at		\$
	Bushings	to in. at		\$
	Red'g			\$
	Inc'g	Coupl'gs to in. at		\$
	Union	in. at		\$
	Meter	in. at		\$
				\$
	Compound Joints	at		\$
	Maintenance Foreman			\$
	Hrs. Water Maint. Man-1	at		\$
	Hrs. Water Maint. Man-2	at		\$
	Hrs. Garage Foreman	at		\$
	Hrs. Labor	at		\$
	Hrs. Compressor	at		\$
				\$
	Trucking			\$
	Pav't Patch			\$
				\$
				\$
				\$
				\$

FIFTH

St. No. 12

Name of Owner  
TAX ID # 309.12-15-9

Labor and Mat'l. Report SEPT. 1 1928

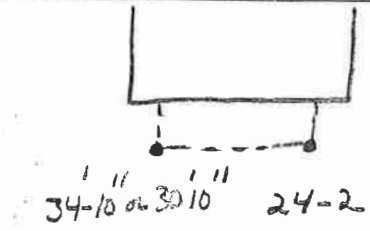

● Curb Box

4" Main      Elev. of Main at tap 5'

Gate at ●      ● Gate at

● Curb Box

OLD TAP SHUT OFF