

LABOR AND MATERIALS


1	Copper	} Connection $\frac{3}{4}$		\$
	Lead			
1	Curb	} Cock Valve } $\frac{3}{4}$ in.		\$
			T-S & V.	
1	Service box	} Short $3\frac{1}{2} \times 4\frac{1}{2}$		\$
	Old returned		Long $4\frac{1}{2} \times 5\frac{1}{2}$	
27	Ft. $\frac{3}{4}$ in.	} Copper } Pipe at		\$
			CS.I.	
	Nipples	in. at		\$
	Bushings	to in. at		\$
	Red'g	} Coupl'gs to in. at		\$
	Inc'g			
	Union	in. at		\$
	Meter	in. at		\$
				\$
	Compound Joints	at		\$
	Maintenance Foreman			\$
	Hrs. Water Maint. Man-1	at		\$
	Hrs. Water Maint. Man-2	at		\$
	Hrs. Garage Foreman	at		\$
	Hrs. Labor	at		\$
	Hrs. Compressor	at		\$
				\$
	Trucking			\$
	Pav't Patch			\$
				\$
				\$
				\$
				\$

FIFTH

St. No. 14
Ave. No. 14

Name of Owner

Labor and Mat'l. Report MAY 28 19 29

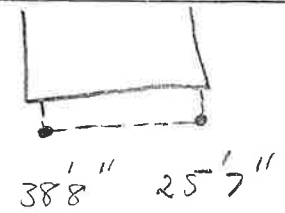

● Curb Box

4" Main

Elev. of Main at tap 5'

Gate at ● ● Gate at

● Curb Box

OLD TO BE DUG UP