


### Labor and Materials

1	<del>Copper</del> Lead	Connection	.....	\$	
1	Curb	Cock Valve To Street	$\frac{3}{4}$ in	\$	
1	Service Box Old returned	Short $3\frac{1}{2} \times 4\frac{1}{2}$ Long $4\frac{1}{2} \times 5\frac{1}{2}$ Ruff on Rdway	} .....	\$	
19	Ft. $\frac{3}{4}$ in.	Copper Galv Iron Cast Iron	} Pipe at .....	\$	
	Nipples	in. at	.....	\$	
	Bushings	to .....	in. at .....	\$	
	Red'g Inc'g	Couplings	to .....	in. at .....	\$
	Union	in. at	.....	\$	
	Meter	in. at	.....	\$	
	Lead Joints	at	.....	\$	
	Leadite Joints	at	.....	\$	
	Hrs. Foreman	at	.....	\$	
	Hrs. Chauffeur	at	.....	\$	
	Hrs. Tapper	at	.....	\$	
	Hrs. Labor	at	.....	\$	
	Hrs. Labor	at	.....	\$	
	Hrs. Compressor	at	.....	\$	
	Compensation Ins.	.....		\$	
	Trucking	.....		\$	
	Builders Use of Water	.....		\$	
				\$	
				\$	
St. ~~Pl.~~  
Ave. No. 21

Name of Owner  
M. G. Rodwin

Labor and Mat'l. Report June 7 1921

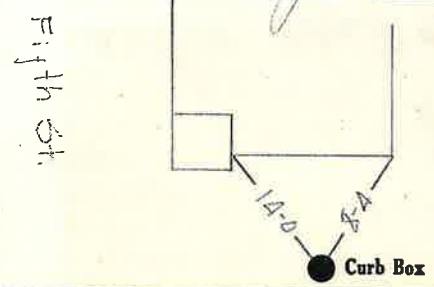

6" Main Big Cross St. Elev. of Main at tap 5

Gate at • • Gate at

● Curb Box

TAP ON BIG CROSS