

LABOR AND MATERIALS

1	Copper Lead	Connection		\$ 1.23
1	Curb	Cock Valve T.S. & V.	3/4 in.	\$ 1.68
1	Service Box Old returned	Short 3 1/2 x 4 1/2 Long 4 1/2 x 5 1/2 Buff or Rdway		\$ 1.75
8	Ft.	3/4 in.	Copper Galv Iron Cast Iron Pipe at 15	\$ 1.20
	Nipples	in. at		\$
	Bushings	to in. at		\$
	Red'g Inc'g	Couplings to in. at		\$
	Union	in. at		\$
	Meter	in. at		\$
	Lead Joints	at		\$
	Leadite Joints	at		\$
	Hrs. Foreman	at		\$
3	Hrs. Chauffeur	at 6 1/2		\$ 1.88
2	Hrs. Tapper	at 7		\$ 1.25
6	Hrs. Labor	at 45		\$ 2.70
	Hrs. Labor	at		\$
	Hrs. Compressor	at		\$
	Compensation Ins.			\$.18
	Trucking			\$ 1.00
	Builders Use of Water	Patch		\$ 5.00
	Taphy Person			\$
				\$
				\$
				\$
				\$ 17.87

70 - 1938

St.

Pr.

Fifth

Ave. No. 29


Name of Owner

TAX ID # 309.11-13-17

Labor and Mat'l. Report

AUG. 12

1938

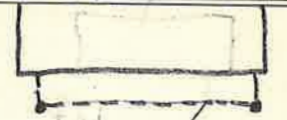

20' 7" 24' 0"

● Curb Box

4" Main

Elev. of

Main at tap 5'

Gate at ●

● Gate at

● Curb Box

old shut off

H.