

LABOR AND MATERIALS

1 Copper } Connection $\frac{3}{4}$ " \$ 1.31
 Lead }
 1 Curb { Cock Valve } $\frac{3}{4}$ " in. \$ 1.75
 T. S. & V. }
 1 Service Box { Short $3\frac{1}{2} \times 4\frac{1}{2}$ }
 Old returned { Long $4\frac{1}{2} \times 5\frac{1}{2}$ } \$ 1.60
 Buff. or Rdway }
 28 Ft. $\frac{3}{4}$ " in. { Copper } Pipe at 18 \$ 5.04
 Galv. Iron }
 Cast Iron }
 Nipples in. at \$
 Bushings to in. at \$
 Red'g } Couplings to in. at \$
 Inc'g }
 Union in. at \$
 Meter in. at \$
 Lead Joints at \$
 Leadite Joints at \$
 Hrs. Foreman at \$
 2 1/4 Hrs. Chauffeur at 6 2/3 \$ 1.41
 1 3/4 Hrs. Tapper at \$ 2.97
 19 Hrs. Labor at 45 \$ 9.55
 Hrs. Labor at \$
 Hrs. Compressor at \$
 Compensation Ins. \$.40
 Trucking \$ 1 -
 Builders Use of Water no patch \$
 Tap by shovel \$
 \$ 24.02

228 - 1940

St.

Flt


Ave. No. 30

Fifth

Name of Owner

Dygert

Labor and Mat'l. Report SEP 24 1940 19

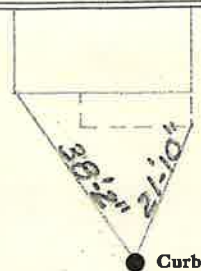

● Curb Box

4" Main

Elev. of Main at tap 5'

Gate at ●

● Gate at

● Curb Box

Old tap shut off SA