

LABOR AND MATERIALS

1	Copper	} Connection	_____	\$
1	Lead		_____	\$
1	Curb	} Cock Valve	_____ in.	\$
			_____	\$
1	Service box	} Short 3 1/2 x 4 1/2	_____	\$
	Old returned		} Long 4 1/2 x 5 1/2	_____
8	Ft. 3/4 in.	} Copper		Pipe at _____
			}	_____
	Nipples	_____ in. at _____		\$
	Bushings	_____ to _____ in. at _____	\$	
	Red'g	} Coupl'gs	_____ to _____ in. at _____	\$
	Inc'g		}	_____
	Union	_____ in. at _____		\$
	Meter	_____ in. at _____	\$	
			_____	\$
	Compound Joints	at _____	\$	
	Maintenance Foreman	_____	\$	
	Hrs. Water Maint. Man-1	at _____	\$	
	Hrs. Water Maint. Man-2	at _____	\$	
	Hrs. Garage Foreman	at _____	\$	
	Hrs. Labor-	at _____	\$	
	Hrs. Compressor	at _____	\$	
			_____	\$
	Trucking	_____	\$	
	Pav't Patch	_____	\$	
			_____	\$
			_____	\$
			_____	\$
			_____	\$

FIFTH


St. Ave. No. 35

Name of Owner

LARBAU

Labor and Mat'l. Report

JUNE 13 1933

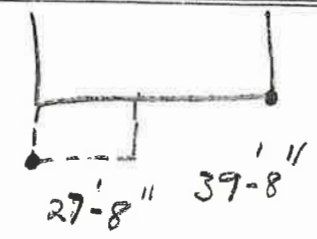

● Curb Box

6" Main

Elev. of Main at tap 4 1/2'

Gate at ●

● Gate at

● Curb Box

NEW HOUSE

TAX ID # 309.11-13-15