

LABOR AND MATERIALS


1	Copper	Connection	\$
1	Lead		
1	Curb	Cock Valve T. S. & V. } in.	\$
1	Service box	Short 3 1/2 x 4 1/2 } Long 4 1/2 x 5 1/2 }	\$
	Old returned		
8	Ft.	3/4 in. { Copper } Pipe at	\$
	Nipples	in. at	\$
	Bushings	to in. at	\$
	Red'g } Inc'g }	Coupl'gs to in. at	\$
	Union	in. at	\$
	Meter	in. at	\$
			\$
	Compound Joints	at	\$
	Maintenance Foreman		\$
	Hrs. Water Maint. Man-1	at	\$
	Hrs. Water Maint. Man-2	at	\$
	Hrs. Garage Foreman	at	\$
	Hrs. Labor	at	\$
	Hrs. Compressor	at	\$
			\$
	Trucking		\$
	Pav't Patch		\$
			\$
			\$
			\$
			\$

FIFTH St. No. 37

Name of Owner

Labor and Mat'l. Report AUG. 18 1933

S  
T  
A  
P  
L  
E

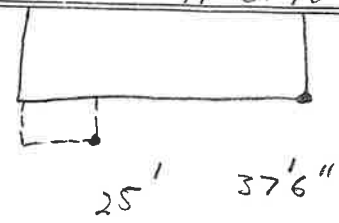

S  
T.

● Curb Box

6" Main FIFTH ST Elev. of Main at tap 5'

Gate at ● Gate at

● Curb Box

NEW HOUSE - LA POINT

TAP ON FIFTH ST.