


Labor and Materials

1	Copper	Connection	3/4	1.48
1	Lead			
1	Curb	Cock Valve	3/4 in	1.79
		T.S. & V.		
1	Service Box	Short 3 1/2 x 4 1/2		1.30
	Old returned	Long 4 1/2 x 6 1/2		
		Butt or Draw		
27	Ft.	Copper	3/4 in	4.86
		Cast Iron		
		Pipe at	3/4	
	Nipples		in. at	
	Bushings		to in. at	
	Red'g Inc'g	Couplings	to in. at	
	Union		in. at	
	Meter		in. at	
	Lbs. Br. Stone		at	
	Lbs. Sand		at	
	Bags Cement		at	
	Paving Brick	Mack Red Asphalt	at	
	Lead Joints		at	
	Leadite Joints		at	
3	Hrs.	Foreman		1.88
6	Hrs.	Common Labor		2.70
	Hrs.	Common Labor		
	Hrs.	Mason		
	Hrs.	Masons Helper		
	Hrs.	Compressor		
	Compensation Ins			14
	Trucking			1
	Builders Use of Water	Patch		2.50
Total \$				17.65

5 32-97
 Labor and Material Report Aug 20 1932

35 Fifth St

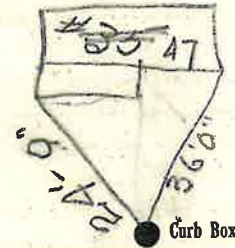

RAZED?

6 Main

Elev. of Main at tap 5

Gate at ●

● Gate at

● Curb Box

New House

(Sewer)

OK EPH