

### LABOR AND MATERIALS


1	Copper / Lead	Connection $3/4"$	\$	2.76	
1	Curb	Cock Valve $3/4"$ in. T. S. & V.	\$	3.49	
1	Service box	Short $3/2 \times 4 1/2$	\$	4.75	
	Old returned	Long $4 1/2 \times 5 1/2$	\$		
		Buff or Rdway	\$		
21	Ft.	$3/4$ in. Copper Pipe at $35$	\$	7.35	
	Nipples	..... in. at	\$		
	Bushings	..... to ..... in. at	\$		
	Red'g		\$		
	Inc'g	Coupl'gs ..... to ..... in. at	\$		
	Union	..... in. at	\$		
	Meter	..... in. at	\$		
	Lead Joints	at	\$		
2	Compound Joints	at $1.44$	\$	2.88	
8	Hrs. Water Maint. Man-1	at $1.34$	\$	10.72	
1	Hrs. Water Maint. Man-2	at $1.24$	\$	1.24	
16	Hrs. Labor	at $1.13$	\$	18.08	
	Hrs. Labor	at	\$		
3	Hrs. Compressor	at $1.50$	\$	4.50	
	Compensation Ins.	at \$3.706 per C	\$	1.22	
	Trucking		\$	1.03	
	Pav't Patch		\$	10.08	
	Tepky Warsinski			\$	
				\$	
				\$	
	O'head		\$		

$$\begin{array}{r} 57.99 \\ 10.08 \\ \hline 68.07 \end{array}$$
 \$68.07

St. Fifth  
 Pl. 51  
 Ave. No: 51

Name of Owner Belden

Labor and Mat'l. Report July 8 1952

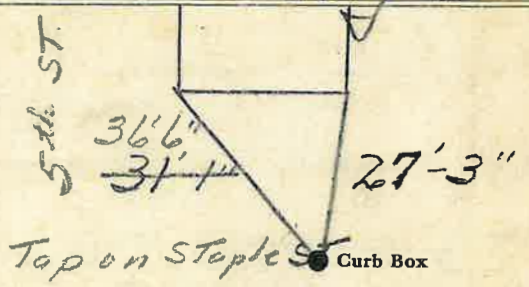

$6''$  Main Elev. of Main at tap  $4 1/2'$

Gate at ● ● Gate at

TAX ID # 309.11-12-33.2

● Curb Box