


LABOR AND MATERIALS

1	Copper	Connection	3/4	\$
1	Curb	Cock Valve T.S. & V.	3/4 in.	\$
1	Service box	Short 3 1/2 x 4 1/2		
	Old returned	Long 4 1/2 x 5 1/2		
		Buff or Rdway		\$
20	3/4 in.	Copper Pipe at		\$
	Nipples	in. at		\$
	Bushings	to in. at		\$
1	Red'g	Coupl'gs	1 to 3/4 in. at	\$
1	Union	3/4 in. at	Male Adapter	\$
	Meter	in. at		\$
	Lead Joints	at		\$
	Compound Joints	at		\$
	Maintenance Foreman			\$
	Hrs. Water Maint. Man-1	at		\$
	Hrs. Water Maint. Man-2	at		\$
	Hrs. Garage Foreman	at		\$
	Hrs. Labor	at		\$
	Hrs. Compressor	at		\$
	Compensation Ins. at \$	per C		\$
	Trucking			\$
	Pav't Patch			\$
	Tap by Gifford & Co			\$
	5-4-59.			\$
	O'head			\$

St. Fifth  
Pl.  
Ave. No. 55

Name of Owner  
Dubrey & Martha Hull

Labor and Mat'l. Report May 4 19 59

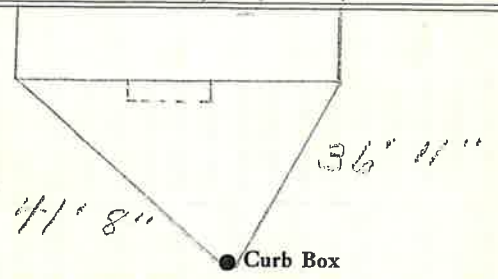

6" Main Elev. of Main at tap 3 1/2'

Gate at • Gate at

• Curb Box