

LABOR AND MATERIALS


1	Copper	} Connection $\frac{3}{4}$	\$
	Lead		
1	Curb	} $\frac{3}{4}$ in.	\$
	Cock		
	Valve		
		T.S. & V.	
1	Service box	} Short $3\frac{1}{2}$ x $4\frac{1}{2}$	\$
	Old returned		
22	Ft. $\frac{3}{4}$ in.	} Copper	\$
		Pipe at	
	Nipples	in. at	\$
	Bushings	to in. at	\$
	Red'g	} Coupl'gs	\$
	Inc'g		
	Union	in. at	\$
	Meter	in. at	\$
			\$
	Compound Joints	at	\$
	Maintenance Foreman		\$
	Hrs. Water Maint. Man—1	at	\$
	Hrs. Water Maint. Man—2	at	\$
	Hrs. Garage Foreman	at	\$
	Hrs. Labor—	at	\$
	Hrs. Compressor	at	\$
			\$
	Trucking		\$
	Pav't Patch		\$
			\$
			\$
			\$
			\$

FIFTH

St. ~~W.~~
Ass. No. 57

Name of Owner

Labor and Mat'l. Report NOV. 21 1927

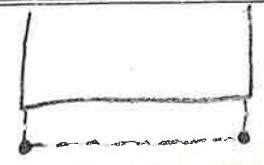

22'3" 32'10"

● Curb Box

6" Main

Elev. of Main at tap $4\frac{1}{2}$ '

Gate at ●

● Gate at

22' to MAIN

● Curb Box

(COLLINS)