

LABOR AND MATERIALS

1	Copper	{ Connection	3/4"	\$	3.04
1	Lead				
1	Curb	{ Cock Valve	3/4 in.	\$	3.54
		{ T.S. & V.			
1	Service box	{ Short 3 1/2 x 4 1/2		\$	4.70
	Old returned	{ Long 4 1/2 x 5 1/2			
		{ Buff or Rdway			
25	Ft. 3/4 in.	{ Copper	Pipe at 35	\$	8.75
		{ C.I.			
		{ C.I.			
	Nipples	in. at		\$	
	Bushings	to in. at		\$	
	Red'g	{ Coupl'gs to in. at		\$	
	Inc'g				
	Union	in. at		\$	
	Meter	in. at		\$	
	Lead Joints	at		\$	
	Compound Joints	at		\$	
1	Hrs. Water Maint. Man-1	at 1.23		\$	1.23
3	Hrs. Water Maint. Man-2	at 1.13		\$	3.39
9 1/2	Hrs. Labor	at 1.02		\$	9.69
	Hrs. Labor	at		\$	
	Hrs. Compressor	at		\$	
	Compensation Ins.	at \$ per C.		\$.38
	Trucking			\$	1.00
	Pav't Patch	Before Paving		\$	
				\$	
				\$	
	O'head			\$	
	Tap by Miller			\$	35.72

7-3-1951

212-51

✓

Fifth


St. ~~Pl.~~ Ave. No. 75

Name of Owner

Trimbo

Labor and Mat'l. Report

July 3 19 51

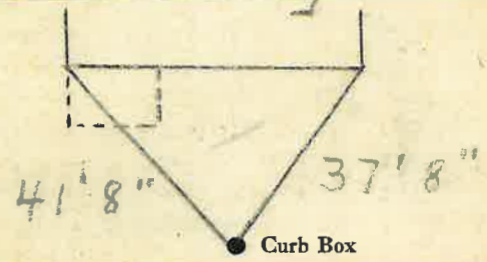

6" Main

Elev. of Main at tap 5'

Gate at ●

● Gate at

TAX ID # 39.11-12-23

● Curb Box

LABOR AND MATERIALS

_____ Copper } Connection _____ \$ _____
 _____ Lead }
 _____ Curb } Cock } _____ in. _____ \$ _____
 _____ Valve }
 _____ T.S. & V. }
 _____ Service box { Short 3-1/2 x 4-1/2 } _____ \$ _____
 _____ Old returned { Long 4-1/2 x 5-1/2 }
 _____ Ft. _____ in. { Copper } Pipe at _____ \$ _____
 _____ { G.I. }
 _____ { C.I. }
 _____ Nipples _____ in. at _____ \$ _____
 _____ Bushings _____ to _____ in. at _____ \$ _____
 _____ Red'g _____
 _____ Inc'g _____
 _____ Union _____ in. at _____ \$ _____
 _____ Meter _____ in. at _____ \$ _____
 _____ \$ _____
 _____ Compound Joints at _____ \$ _____
 _____ Maintenance Foreman _____ \$ _____
 _____ Hrs. Water Maint. Man - 1 at _____ \$ _____
 _____ Hrs. Water Maint. Man - 2 at _____ \$ _____
 _____ Hrs. Garage Foreman _____ at _____ \$ _____
 _____ Hrs. Labor _____ at _____ \$ _____
 _____ Hrs. Compressor at _____ \$ _____
 _____ \$ _____
 _____ Trucking _____ \$ _____
 _____ Pav't Patch _____ \$ _____
 _____ \$ _____
 _____ \$ _____
5th ST. ~~St~~ 5th St
 Pl. Ave. No. 75

Name of Owner _____
 Labor and Mat'l. Report 19 2017

