


LABOR AND MATERIALS

1	Copper	} Connection	3/4	\$	_____
1	Curb				
		} Cock	3/4 in.	\$	_____
		} Short 3 1/2 x 4 1/2	}	\$	_____
12	Ft. 3/4 in.	} Copper	}	\$	_____
	Nipples	in. at	\$	_____	
	Bushings	to in. at	\$	_____	
	Red'g	} Coupl'gs	to in. at	\$	_____
	Inc'g				
	Union	in. at	\$	_____	
	Meter	in. at	\$	_____	
	Compound Joints	at	\$	_____	
	Maintenance Foreman		\$	_____	
	Hrs. Water Maint. Man—1	at	\$	_____	
	Hrs. Water Maint. Man—2	at	\$	_____	
	Hrs. Garage Foreman	at	\$	_____	
	Hrs. Labor—	at	\$	_____	
	Hrs. Compressor	at	\$	_____	
	Trucking		\$	_____	
	Pav't Patch		\$	_____	
			\$	_____	
			\$	_____	
			\$	_____	
			\$	_____	

St. No. 5  
FIFTH  
 Name of Owner \_\_\_\_\_

Labor and Mat'l. Report SEPT. 29 1925

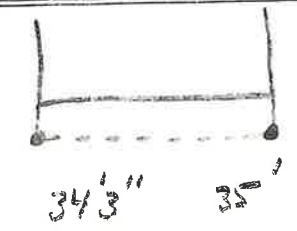

● Curb Box

4" Main Elev. of Main at tap 5'  
 Gate at ● Gate at

● Curb Box