

LABOR AND MATERIALS

1	Copper	{ Connection	3/4"	\$	3.04
	Lead				
1	Curb	{ Cock Valve	3/4 in.	\$	3.54
		{ P.S. & V.			
1	Service box	{ Short 3 1/2 x 4 1/2		\$	4.70
	Old returned	{ Long 4 1/2 x 5 1/2			
		{ Buff or Rdway			
25	Ft.	{ Copper	Pipe at 35	\$	9.75
	3/4 in.	{ C.I.			
		{ C.I.			
	Nipples	in. at		\$	
	Bushings	to in. at		\$	
	Red'g	{ Coupl'gs	to in. at	\$	
	Ine'g				
	Union	in. at		\$	
	Meter	in. at		\$	
	Lead Joints at			\$	
	Compound Joints at			\$	
1	Hrs. Water Maint. Man-1	at 1.23		\$	1.23
3	Hrs. Water Maint. Man-2	at 1.13		\$	3.39
9 1/2	Hrs. Labor	at 1.02		\$	9.69
	Hrs. Labor	at		\$	
	Hrs. Compressor at			\$	
	Compensation Ins. at \$	per C.		\$	38
	Trucking			\$	1.00
	Pav't Patch			\$	
				\$	
				\$	
				\$	
	O'head			\$	
				\$	35.72

Tap made by Miller
July 3-51


149-1951

Fieth

St. Pl. Ave. No. 79

Name of Owner
Trimbey

Labor and Mat'l. Report July 3 1951

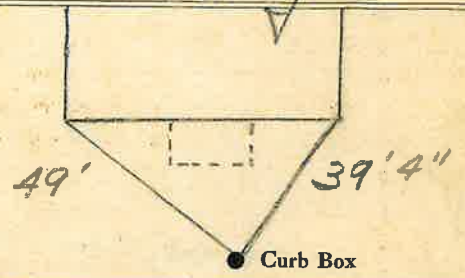

6 Main Elev. of Main at tap 4'
Gate at • Gate at

• Curb Box