


LABOR AND MATERIALS

1	Copper Lead	Connection	3/4"	\$	_____
1	Curb	Cock Valve T.S. & V.	3/4 in.	\$	_____
1	Service box	Short 3 1/2 x 4 1/2	}	\$	_____
	Old returned	Long 4 1/2 x 5 1/2			
29	Ft.	Buff or Rdway		\$	_____
	3/4 in.	Copper	}	\$	_____
		G.I.			
		C.I.			
	Nipples	in. at		\$	_____
	Bushings	to in. at		\$	_____
	Red'g Inc'g	Coupl'gs	to in. at	\$	_____
	Union	in. at		\$	_____
	Meter	in. at		\$	_____
	Lead Joints	at		\$	_____
	Compound Joints	at		\$	_____
	Maintenance Foreman			\$	_____
	Hrs. Water Maint. Man	1 at		\$	_____
	Hrs. Water Maint. Man	2 at		\$	_____
	Hrs. Garage Foreman	at		\$	_____
	Hrs. Labor	at		\$	_____
	Hrs. Compressor	at		\$	_____
	Compensation Ins.	at \$ _____ per C.		\$	_____
	Trucking			\$	_____
	Pav't Patch			\$	_____
	Tap by Gifford			\$	_____
	7-5-60			\$	_____
	O'head			\$	_____
				\$	_____

St. Pl.
Ave. No. 81

Name of Owner
Herman W. Newcomb

Labor and Mat'l. Report July 5 1960

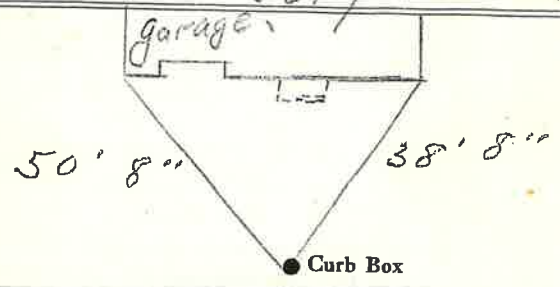

6" Main Elev. of Main at tap 5'
Gate at • Gate at •

• Curb Box