

LABOR AND MATERIALS

1	Copper	} Connection	3/4"	\$	
	Lead				
1	Curb	} Cock	3/4 in. Orisgal	\$	
					} Valve
		T.S. & V.			
1	Service box	} {	Short 3 1/2 x 4 1/2	\$	
	Old returned				} Long 4 1/2 x 5 1/2
24	Ft. 3/4 in.	} {	Copper	} Pipe at	\$
		C.I.			
	Nipples	in. at	\$		
	Bushings	to in. at	\$		
	Red'g	} Coupl'gs	to in. at	\$	
	Inc'g				
	Union	in. at	\$		
	Meter	in. at	\$		
	Lead Joints	at	\$		
	Compound Joints	at	\$		
	Maintenance Foreman		\$		
	Hrs. Water Maint. Man-1	at	\$		
	Hrs. Water Maint. Man-2	at	\$		
	Hrs. Garage Foreman	at	\$		
	Hrs. Labor	at	\$		
	Hrs. Compressor	at	\$		
	Compensation Ins. at \$	per C	\$		
	Trucking		\$		
	Pav't Patch		\$		
	Tap by Kelly & Miller.			\$	
	7-29-64.			\$	
	O'head		\$		
			\$		

Fifth


St. ~~Pl.~~ Ave. No. 83

Name of Owner

William F. Reynolds

Labor and Mat'l. Report

July 29 1964

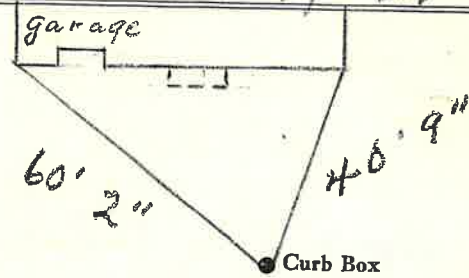

6" C.I.
Main

Elev. of
Main at tap 5'

Gate at ●

● Gate at

● Curb Box