

LABOR AND MATERIALS

1	Copper Lead	Connection	3/4"	\$	2.29
1	Curb	Cock Valve T.S. & V.	3/4" in.	\$	2.70
1	Service box Old returned	Short 3 1/2 x 4 1/2 Long 4 1/2 x 5 1/2 Buff or Rdway		\$	4.25
11	Ft. 3/4 in.	Copper G.I. C.I.	Pipe at	35 \$	3.85
	Nipples	in. at		\$	
	Bushings	to in. at		\$	
	Red'g Inc'g	Coupl'gs to in. at		\$	
	Union	in. at		\$	
	Meter	in. at		\$	
	Lead Joints	at		\$	
	Compound Joints	at		\$	
	Hrs. Water Maint. Man-1	at		\$	
3	Hrs. Water Maint. Man-2	at	1.02	\$	3.06
16	Hrs. Labor	at	91	\$	14.56
	Hrs. Labor	at		\$	
	Hrs. Compressor	at		\$	
	Compensation Ins. at \$	per C.		\$	39
	Trucking			\$	1.00
	Pay't Patch			\$	
	Tap by Moquin			\$	
	O'head			\$	
				\$	32.10

155-1950

St. PI- Ave. No. 86


Fifth

Name of Owner

Trimbay

Labor and Mat'l. Report

Sept 28 19 50

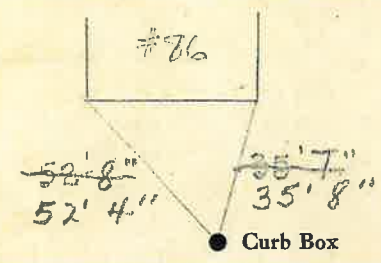

6" Main

Elev. of Main at tap 5'

Gate at ●

● Gate at

● Curb Box