

LABOR AND MATERIALS

1	Copper	{ Connection	3/4	\$ 3.04
1	Lead	{ Cock	3/4 in.	\$ 3.54
		{ Valve		
		{ T.S. & V.		
1	Service box	{ Short 3 1/2 x 4 1/2		
	Old returned	{ Long 4 1/2 x 5 1/2		\$ 4.70
		{ Buff or Rdway		
12	Ft. 3/4 in.	{ Copper	Pipe at 35	\$ 4.20
		{ C.I.		
		{ C.I.		
	Nipples	in. at		\$
	Bushings	to in. at		\$
	Red'g	{ Coupl'gs to in. at		\$
	Inc'g			
	Union	in. at		\$
	Meter	in. at		\$
	Lead Joints at			\$
	Compound Joints at			\$
	Hrs. Water Maint. Man-1 at			\$
	Hrs. Water Maint. Man-2 at			\$
2	Hrs. Labor - AM	at 1.26		\$ 2.52
5	Hrs. Labor	at 1.02		\$ 5.10
	Hrs. Compressor at			\$
	Compensation Ins. at \$ 2.66 per C.			\$ 2.00
	Trucking			\$ 1.00
	Pav't Patch			\$
				\$
				\$
	O'head			\$

Tap by Lakeau
4-6-51
\$ 24.30

24.30


Fifth

St. Pl. Ave. No. 94

Name of Owner

Trimbey

Labor and Mat'l. Report 4-6-1957

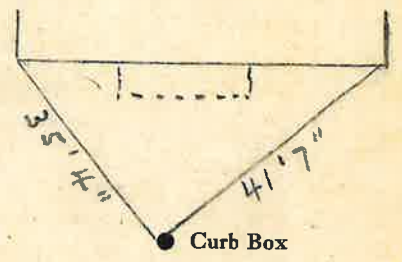

6" Main Elev. of Main at tap 5'
Gate at ● Gate at ●

● Curb Box