


LABOR AND MATERIALS

- BRASS*
- 1 ~~Copper~~ } Connection _____ \$ _____
 - ~~Lead~~ }
 - Curb } Cock } $\frac{3}{4}$ in. _____ \$ _____
 - } Valve }
 - } T.S. & V. }
 - 1 Service box { Short 3-1/2 x 4-1/2 } _____ \$ _____
 - Old returned { Long 4-1/2 x 6-1/2 }
 - 23 Ft. $\frac{3}{4}$ in. { Copper } Pipe at _____ \$ _____
 - ~~C.P.~~ }
 - ~~Gal.~~ }
 - Nipples _____ in. at _____ \$ _____
 - Bushings _____ to _____ in. at _____ \$ _____
 - Red'g _____
 - Inc'g _____
 - Union _____ in. at _____ \$ _____
 - Meter _____ in. at _____ \$ _____
 - _____ \$ _____
 - _____ Compound Joints at _____ \$ _____
 - _____ Maintenance Foreman _____ \$ _____
 - _____ Hrs. Water Maint. Man - 1 at _____ \$ _____
 - _____ Hrs. Water Maint. Man - 2 at _____ \$ _____
 - _____ Hrs. Garage Foreman _____ at _____ \$ _____
 - _____ Hrs. Labor _____ at _____ \$ _____
 - _____ Hrs. Compressor at _____ \$ _____
 - _____ \$ _____
 - _____ Trucking _____ \$ _____
 - _____ Pav't Patch _____ \$ _____
 - _____ \$ _____
 - _____ \$ _____
FIRST St. 1
~~St.~~ Ave. No. 1
 Name of Owner _____

Labor and Mat'l. Report 19 _____

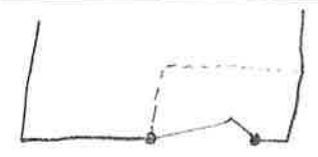

24'2" 30'7"

● Curb Box

6" Main Elev. of Main at tap 5'
 Gate at ● Gate at ●

● Curb Box