

LABOR AND MATERIALS

1 Copper Lead } Connection	3/4	\$	1.78
1 Curb } Clock Valve	3/4 in.	\$	2.61
Service box } Short 3"X4"	Same	\$	—
Old returned } Long 4"X5"	Same	\$	—
10 Ft. 3/4 in. }	Copper Galv. Iron Cast Iron	Pipe at 23	\$ 2.30
Nipples	in. at	\$	—
Bushings	to in. at	\$	—
Red'g Inc'g } Couplings	to in. at	\$	—
Union	in. at	\$	—
Meter	in. at	\$	—
Lead Joints at		\$	—
Compound Joints at		\$	—
Hrs. Foreman at		\$	—
Hrs. Chauffeur at		\$	—
7 Hrs. Tapper at	7.5	\$	525.00
6 Hrs. Labor at	6.5	\$	390.00
Hrs. Labor at		\$	—
Hrs. Compressor at		\$	—
Compensation Ins.		\$	25
Trucking		\$	1.00
Builders Use of Water		\$	5.00
<i>Tap by Wagon</i>			
			\$ 22.09

24-46


First

St.
Pt. No. 1B
Ave. No.

Name of Owner

Forth

Labor and Mat'l. Report May 13 1946

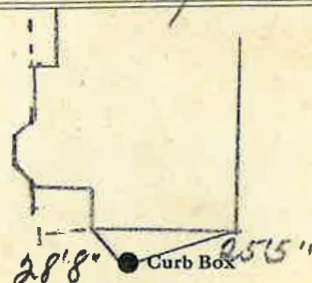

FIRST ST

6 Main

Elev. of Main at tap 5 1/2

Gate at ●

● Gate at

TAX ID # 309.12-9-12

● Curb Box