


LABOR AND MATERIALS

1	Copper	Connection	$\frac{3}{4}$	\$	_____
1	Curb	Cock Valve T.S. & V.	$\frac{3}{4}$ in.	\$	_____
1	Service box Old returned	{ Short 3-1/2 x 4-1/2 long 4-1/2 x 5-1/2 }		\$	_____
26	Ft.	$\frac{3}{4}$ in. Copper	Pipe at	\$	_____
_____	Nipples	_____ in.	at	\$	_____
_____	Bushings	_____ to _____ in.	at	\$	_____
_____	Red'g			\$	_____
_____	Inc'g			\$	_____
_____	Union	_____ in.	at	\$	_____
_____	Meter	_____ in.	at	\$	_____
_____	Compound Joints	at		\$	_____
_____	Maintenance Foreman			\$	_____
_____	Hrs. Water Maint. Man - 1	at		\$	_____
_____	Hrs. Water Maint. Man - 2	at		\$	_____
_____	Hrs. Garage Foreman	at		\$	_____
_____	Hrs. Labor	at		\$	_____
_____	Hrs. Compressor	at		\$	_____
_____	Trucking			\$	_____
_____	Pav't Patch			\$	_____
_____				\$	_____
_____				\$	_____
St. FIRST Ave. No. 15
 Name of Owner _____

Labor and Mat'l. Report OCT. 2, 1930

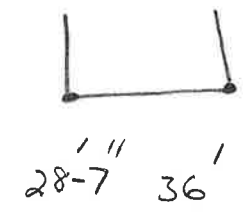

● Curb Box

6" Main Elev. of Main at tap 5'
 Gate at ● Gate at ●

● Curb Box

OLD TAP DISCONNECTED